


Exhibit "A"

65'-0"

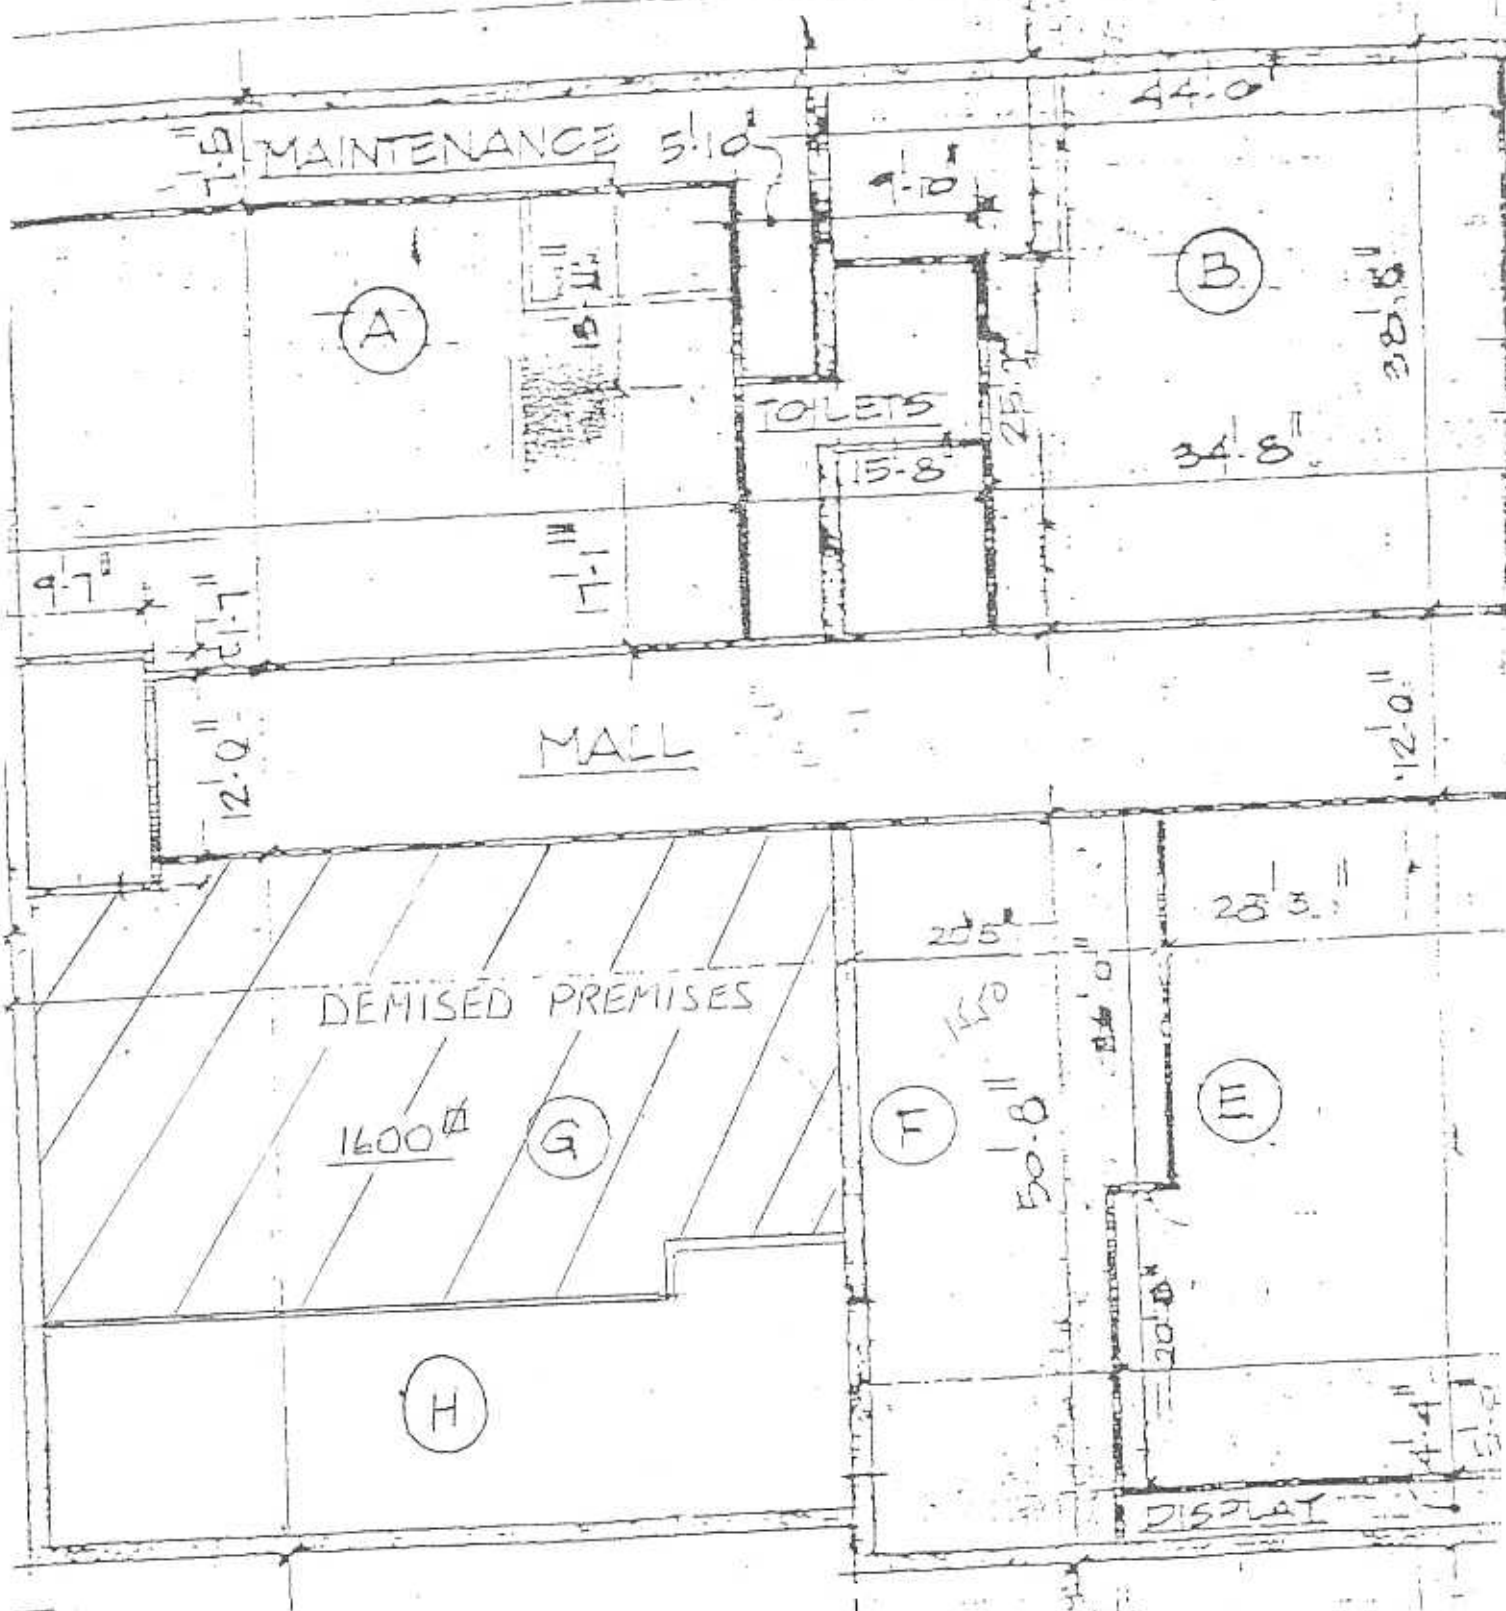

AS BUILT FLOOR PLAN

103
90
19